



City of Bellevue, Development Services Department
P.O. Box 90012, Bellevue, WA 98009-9012
(425) 452-6800 Fax (425) 452-5225

**SHORELINE MANAGEMENT ACT OF 1971
PERMIT FOR SHORELINE SUBSTANTIAL DEVELOPMENT PERMIT**

CITY FILE NO. 18-110706-WG	DATE OF APPLICATION: 4/6/2018
DECISION: Approved DATE OF DECISION: 8/30/2018	
Pursuant to Chapter 90.58 RCW, this permit is hereby granted to Puget Sound Energy to undertake the following development: relocate an existing utilities pole within City of Bellevue right of way as shown on plans dated 8/16/2017 upon the property located at 4839 Lakehurst Lane .	
The project is located in or within 200 feet of Lake Washington , a "Shoreline of Statewide Significance" (RCW 90.58.030), and/or its associated wetlands. These areas are within the Shoreline Overlay District of the City of Bellevue, Land Use Code 20.25E. This proposal conforms to the applicable shoreline master program provisions.	
Development pursuant to this permit shall be undertaken in accordance with the following terms and conditions: No Conditions.	

This permit is granted pursuant to the Shoreline Management Act of 1971 and nothing in this permit shall excuse the applicant from compliance with any other federal, state or local statutes, ordinances or regulations applicable to this project, but not inconsistent with the Shoreline Management Act (Chapter 90.58 RCW).

This permit may be rescinded pursuant to RCW 90.58.140(8) in the event the permittee fails to comply with the terms and conditions hereof. Construction pursuant to this permit, or substantial progress toward construction, must be undertaken within two years of the date of final approval. This permit shall expire five years from the date of local approval.


Construction pursuant to this permit will not begin or is not authorized until twenty-one (21) days from the "date of filing," as defined in RCW 90.58.140(6) and WAC 173-27-130, or until all review proceedings initiated within twenty-one (21) days from the date of such filing have terminated; except as provided in RCW 90.58.140(5) (A) (B) (C) (D).

8/30/2018

Date


City of Bellevue, Land Use Division

CC: Attorney General, Department of Ecology, Northwest Region
Dept. of Fish and Wildlife, 1775 12th Ave. NW Suite 201 Issaquah, WA 98027
DOE, Joe Burcar, 3190 160th Avenue SE, Bellevue, WA 98008-5452

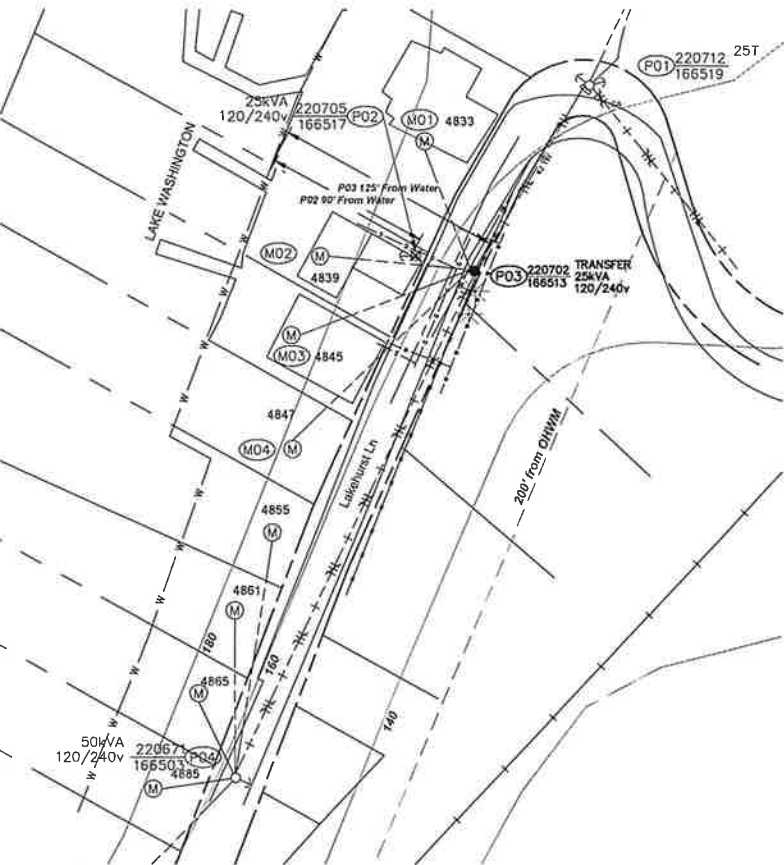

SITE PLAN
SCALE: 1" = 50'


TRANSFORMER TRANSFER

Removed at site: P02
Grid Number: 220705-166517
kVA Rating: 25kVA


Transferred to site: P03
Grid Number: 220702-166513
kVA Rating: 25kVA

Foreman to redline the following information

Company ID#: _____
Primary phase connected to: _____
Tested Secondary Voltage: _____

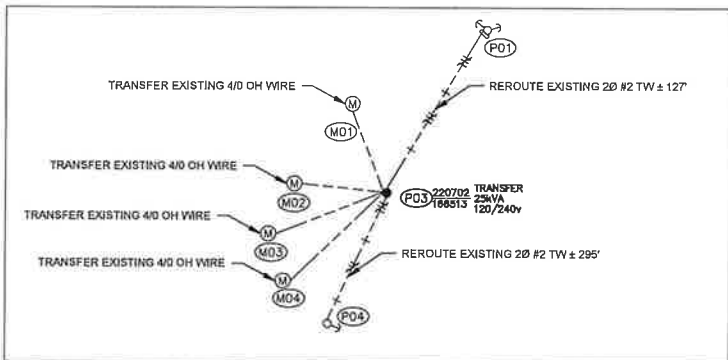

CIRCUIT ONE-LINE DIAGRAM
SCALE: 6" = 1 MILE

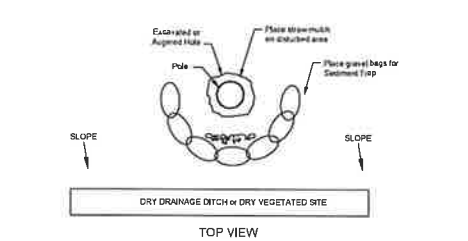

UTILITY POLE EROSION CONTROL DETAIL
Not to scale Drainage ditches or Dry vegetated sites

SITE SPECIFIC NOTES

SITE NOTES

- P01 (220712-166519)
 - EXISTING POLE TO REMAIN
- P02 (220705-166517)
 - REMOVE POLE
 - TRANSFER OH 25kVA TRANSFORMER WITH LB C/O TO P03
 - TRANSFER AMR UNIT TO P03
 - REMOVE DOWN GUY AND ANCHOR
- P03 (220702-166513)
 - INSTALL 45 FOOT CL-1 POLE AND DEEP SET
 - INSTALL 1Ø SINGLE WINGARM (TASW112) PER STD, 6031.4010
 - TRANSFER EXISTING 25kVA OH TRANSFORMER W/ LB C/O AND TAP AØ FROM P02
 - TRANSFER EXISTING AMR UNIT FROM P02
 - INSTALL (1) RIGID CLEVIS
 - INSTALL GRID NUMBER 220702-166513
- P04 (220671-166503)
 - EXISTING POLE TO REMAIN

SHORELINE PERMITTING NOTES:

- P02 TO WATER LINE ~90'
- P03 TO WATER LINE ~125'
- SOIL TO BE TEMPORARILY DISPLACED AT P03 (5' SET DEPTH), ~20', BY AUGER
- NO STORM DRAINS WITHIN WORK ZONE

SPAN NOTES

- P01 TO P03
 - REROUTE EXISTING #2 2Ø TW FROM P01-P02 ± 127'
- P03 TO P04
 - REROUTE EXISTING #2 2Ø TW FROM P02-P04 ± 295'
- P02 TO M01; M02; M03; M04
 - TRANSFER EXISTING SERVICES TO P03
- P03 TO M01; M02; M03; M04
 - TRANSFER EXISTING 4/0 OH SERVICE WIRE; EXTEND AS NECESSARY

POLE RETIREMENT TABLE							TEMP TRANSFERS			ST. LIGHT TRANSFERS		
SITE #	POLE DATA				POLE		TEL	TV	FIBER	TRAN	RMVD	ID NUMBER
	GRID #	HEIGHT	CLASS	YEAR	TOPPED	RMVD						
P02	220705-166517	50	2	1999	<input type="checkbox"/>	<input type="checkbox"/>	<input type="checkbox"/>	<input type="checkbox"/>	<input type="checkbox"/>	<input type="checkbox"/>	<input type="checkbox"/>	

POLE TABLE (NEW)						
Site #	Pole Data					
	Grid #	Height	Class	Year	Remarks / Location Ref.	
P03	220702-166513	45	1	2017	PSE Equip #	

FOREMAN (CHECK BOX WHEN COMPLETED)

☐ PSE Equipment LOCKED/SECURED & Work Area left in CLEAN/SAFE Condition.

☐ Grid, Cable, and Switch numbers INSTALLED & VERIFIED.

☐ Field Changes RED-LINED on As-built.

☐ Material VERIFIED and CHANGES noted on Paperwork.

☐ Total PRIMARY cable noted on As-built.

☐ Company ID's RECORDED in record location on As-built.

☐ Indicate correct FUSE SIZE on As-built & VERIFY proper PHASE.

☐ Deviations noted on the As-built and their reason.

☐ I certify that the work performed meets PSE's standards and procedures and that all quality requirements are met.

Foreman's Signature _____

Print Name _____ Date _____

PROJECT PHASE	NOTIF #	ORDER#
PWR	Superior 504828039	101107216
Removal		108102376
OH Misc		593187342
Perm SVC	504828012	101107217
Removal		108102377
Job Order		
GAS	Distribution	
HP Main		
HP Svc/MSA		
CABLE TV		
PHONE		

Project Manager Contact Information:

Manager: Kim Morris
Cell Phone: 253-261-5562
E-Mail: Kimberly.Morris@pse.com

Vicinity Map



Owner / Developer Contact Info

Nicholas and Dierle Paget
4839 Lakehurst Lane
Bellevue, WA 98006
ATTN: Nicholas Paget 425-444-0843 office

For contacts below dial 1-888-CALL PSE (225-5773)

Developer: Yes x No x PSE

"Locates Required" Yes x No x

"Outages Required" Yes x No x

"Flagging Required" Yes x No x

THIS SKETCH NOT TO BE RELIED UPON FOR EXACT LOCATION OF EXISTING FACILITIES

REV#	DATE	BY	DESCRIPTION	FUNCTION	CONTACT	PHONE NO	DATE
3				PROJECT MGR	Kim Morris	253-261-5562	1/16/2017
2				ENGR - POWER	Kim Morris	253-261-5562	1/16/2017
1				ENGR - GAS	C. Pompeani	253-208-2655	8/16/2017

COUNTY: King Emer Sect Gas Vlk Ctr POWER WK CTR CSPSKEIN

1/4 SEC DRAWN BY CHECKED BY C. Pompeani

24N DSE ZONE OP MAP PLAT MAP APPROVED BY FOREMAN #1

U/MAP NO (POWER) OH CKT MAP UG CKT MAP CIRCUIT NO FOREMAN #2

2409E017 2409G08B 2409E017 5036-16 MAPPING

UTILITIES	CONTACT	PHONE
Century Link		
Comcast		
Cednet Landis		

Nicholas Paget
Replace/Relocate Pole
4839 Lakehurst Ln SE Bellevue, WA 98006

INCIDENT MAOP
Gas Order Elect Order
SCALE PAGE
AS NOTED 1 of 1